CITY OF DANA POINT PLANNING COMMISSION AGENDA REPORT

DATE:

NOVEMBER 27, 2017

TO:

DANA POINT PLANNING COMMISSION

FROM:

COMMUNITY DEVELOPMENT DEPARTMENT

URSULA LUNA-REYNOSA, DIRECTOR JOHN CIAMPA, SENIOR PLANNER

SUBJECT:

PRELIMINARY REVIEW (PA17-0075) FOR A GENERAL PLAN AMENDMENT, VARIANCE, CONDITIONAL USE PERMIT, AND TENTATIVE PARCEL MAP TO LEGALIZE THE NONCONFORMITIES OF THE SITE TO ALLOW A CONDOMINIUM CONVERSION FOR THE APARTMENTS AT 33950 AND 33952 COPPER LANTERN STREET

AND 33961 MARIANA DRIVE

RECOMMENDATION:

That the Planning Commission assesses the request and provide feedback to the applicant focusing on potential issues

which may be raised during consideration of a formal

submittal for the project.

APPLICANT:

Robert Williams, Studio 6 Architects

PROPERTY OWNERS:

Real Estate Advisors

REQUEST:

Preliminary review for a General Plan Amendment, Variance, Conditional Use Permit, and a Tentative Parcel Map to legalize the nonconformities associated with the property, increase the density of the site for a fourth unit, and to allow a condominium conversion for the apartments located at 33950 and 33952 Copper Lantern Street and 33961 Mariana Drive.

LOCATION:

33950 & 33952 Copper Lantern Street and 33961 Mariana

Drive (APN: 682-123-18)

NOTICE:

No noticing is required.

ENVIRONMENTAL:

Not applicable at this time.

ISSUES:

 Project consistency with the Dana Point General Plan and the Dana Point Zoning Code (DPZC).

- Project land use compatibility and community values.
- Findings for Variances.

BACKGROUND:

The subject site is a triangular lot located on the corner of Copper Lantern and Mariana Drive, bordered by single and multiple-family structures. The subject site is located in the Residential Multiple Family 14 (RMF-14) Zoning District and is designated Residential 14 - 22 D.U./AC in the City's General Plan. The property is improved with three detached residential structures that were developed over the course of approximately 10 years during the 1950s and 1960s.

Over the years as the property was being developed there were a number of permits and entitlements that were issued, the most significant permits and entitlements include the following:

- 1) in 1962, a Variance was issued to Unit B (33952 Copper Lantern) for a reduction in the front yard setback to 7.3 feet and five feet from the northerly property line; and
- 2) in 1968, one of the garage spaces for Unit A-1 was converted to a "Rumpus Room" for additional living area and a carport was added with a Variance for a reduced setback from the north property line to 4.5 feet. The permit for the "Rumpus Room" which is technically part of unit A-1, but did not allow for the legalization of a fourth unit (Unit A-2); and
- 3) the County of Orange approved a Lot Line Adjustment (LLA) for Unit B (33952 Copper Lantern) because the structure was incorrectly located over the property line along Mariana Drive; and
- 4) in 1968, a Variance issued to Unit-B (33952 Copper Lantern) to allow a reduced setback of 7.5 feet along Copper Lantern.

In 2006, the property owner submitted an application to convert the apartments on the subject property to condominiums. In the review of the application, City staff identified a number of non-conforming issues associated with the property that would require Variances to permit the condominium conversion. Staff notified the applicant that because of the amount of Variances required for the project, staff would not recommend approval to the Planning Commission. As a result of staff's communication, the applicant withdrew the project.

Recently the property owner hired a new architect to see if the past issues on the proposed project had changed and if the City would be more inclined to allow a condominium conversion for the property. The applicant requested a preliminary application review by City staff and the Planning Commission to obtain direction and input for the project.

The request for a condominium conversion for the subject property will require a Tentative Parcel Map (TPM) pursuant to Section 7.05.060 of the City's Subdivision Ordinance and Conditional Use Permit to allow condominium units. Variances must be approved to legalize the nonconformities associated with the site since condominium conversions are required to comply with all applicable development standards, per Section 7.05.055 of the Dana Point Municipal Code.

Preliminary Review:

Pursuant to Section 9.61.100(a)(2), a preliminary review by the Planning Commission is a more formal option made available to the applicant to provide feedback on a potential project. This process includes a brief evaluation of the project provided to the Planning Commission under the "New Business" section of the meeting. The applicant will have the opportunity to present the proposal directly to the Planning Commission and discuss the issues associated with the project. The objective of the review is to identify issues and possible solutions pertinent to the proposed project; however, the Planning Commission is legally limited in the type and amount of input they can provide during the preliminary review. Commissioner comments and feedback should be focused on the identification of potential issues which may be raised during consideration of a formal submittal.

DISCUSSION:

Staff conducted the preliminary review of the proposal and confirmed that the site still has a number of nonconformities associated with the property that would require Variances to allow the condominium conversion and permit a fourth unit. Upon staff's completed review the applicant was notified that if the project were formally submitted, it would not be supported to Planning Commission. To further vet the project, the applicant requested the Planning Commission conduct a preliminary review to obtain additional input to determine if they should move forward with the project. The applicant is requesting Planning Commission feedback on the necessary Variances for the parking, setbacks, open space, and density requirements to legalize the nonconformities and permit the condominium conversion.

Parking Variances

Pursuant to Section 9.35.080(e)(8), Minimum Number of Required Parking Stalls, the project's multi-family use requires a total of seven parking spaces (4 covered and 3 uncovered). The site is nonconforming because it provides a total of five covered parking spaces, of which four are substandard in size because they do not comply with the 10'x20' dimension requirement. The driveway areas behind the garages (tandem spaces) cannot count towards legal parking spaces because tandem parking is only allowed for duplexes, with the approval of a Minor Conditional Use Permit, per Section 9.35.080(e)(5). A breakdown of the parking required and provided for the site is detailed

in Table-1 below.

Table-1 Parking Standards

Unit #	Required Parking	Provided Parking	Compliance w/	
			Required	
			Dimensions	
Unit A-1 (1- bedroom)	1.7	1	No	
Unit A-2 (1- bedroom)	1.7	1	Yes	
(proposed unit)				
Unit B (1- bedroom)	1.7	2	No	
Unit C (2-bedroom)	2.2	1	No	
Totals	7*	5		

^{*}The total 7.3 parking spaces is rounded down to seven per Section 9.35.080(a) because the total was a fractional number less than 0.5.


Setback Variances

The three structures are all legal nonconforming because they do not comply with one or more of the setback requirements identified under Section 9.09 of the DPZC. Due to the property's unique configuration the front lot line is along Mariana and the exterior side property line is along Copper Lantern. Per Section 9.05.190(a) of the DPZC, the substandard size of the lot allows for a reduction in the required front yard setback from 20 feet to 10 feet. The number of nonconformities associated with the structures' setbacks are related to the change in the development standards over the years and/or the incorrect placement of the structure on the lot.

Unit-B (33952 Copper Lantern) is nonconforming because it was incorrectly located over the property line and in the City Right-of-Way along Mariana Drive. To address the nonconforming encroachment, the County approved a LLA to reposition the property line around the exterior of the structure; however, the new property line did not provide adequate setbacks from the structure to comply with the City's setback requirements. The property line relocation resulted in the structure being setback 1.7 and 2 feet from Marina Drive when 10 feet is required. The structure is also nonconforming because a Variance was issued in 1968 to allow a setback of 7.5 feet from Copper Lantern when 10 feet is required; however, the structure only provides a 5.2 setback.

Pursuant to Sections 9.09.030 and 9.35.050(b)(5)(2) of the DPZC, the structures must comply with the required 10 foot exterior side and front yard setback for the primary structure and 20 feet for the garages, respectively. Unit A-1 (33950 Copper Lantern) is a nonconforming structure because it only provides a 7.2 foot exterior side yard and garage setback. The structure is also nonconforming because the deck along Copper Lantern is located over the property line and would need to be relocated behind the front property line and setback in accordance with the provisions identified in Maximum Projection Section 9.05.080 of the DPZC.

The image below and Supporting Document 4 (Plans) illustrates the structures' nonconformities with the RMF-14 development standards.

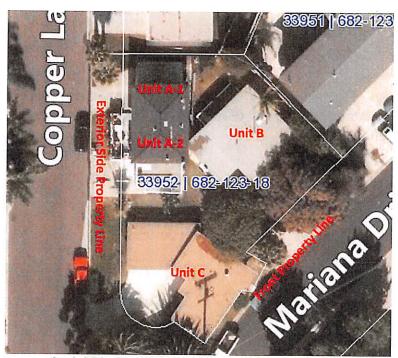

Aerial Photo of Project Site and Property Lines

Pursuant to Section 9.09.030(I) of the DPZC, a minimum separation of 10 feet is required between buildings on the same lot. The applicant is requesting relief from the required 10-foot building separation to three feet between Unit A-1 (33950 Copper Lantern) and Unit C (33961 Marina Drive). A reduction from the required 10-foot minimum building separation would be necessary in order avoid portions of the structures from being demolished to provide the required building separation. The reduction in the separation between buildings may also impact the 200 square foot private open space requirement per unit (DPZC Section 9.09.030.j); however, compliance with this provision would need to be evaluated during the formal application review process.

General Plan Amendment and Zone Change/Conversion of Illegal Unit

The subject property is a 7,908 square foot lot in the Residential Multiple Family 14 (RMF-14) Zoning District and Residential 14 - 22 D.U./AC land use designation in the City's General Plan. The land use designation for the property allows for one unit per 2,600 square feet of lot area which only permits three units for the poperty. The request to legalize unit A-2 as a fourth unit would require a General Plan Amendment (GPA) and Zone Change to exceed the allowed density for the site which would be considered spot zoning. Per Section 9.61.080(b) of the DPZC, the General Plan Amendment must be initiated by the City Council.

Planning Commission Agenda Report PA17-0075 November 27, 2017 Page 6

CORRESPONDENCE:

None.

CONCLUSION:

Staff requests that the Planning Commission review the subject proposal and provide the applicant with comments and feedback in moving forward with a formal discretionary application submittal.

John Ciampa Senior Planner Ursula Luna-Reynosa, Director Community Development Department

ATTACHMENTS:

- 1. Vicinity Map
- 2. Variance Findings (Section 9.67.050 of the DPZC)
- 3. Site Photos
- 4. Project Plans



Vicinity Map

33952 Copper Lantern, Pre Application PA17-0075



Dana Point Municipal Code

<u>Up</u> <u>Previous</u>

<u>is Next</u>

<u>Main</u>

Search

Print

No Frames

Title 9 ZONING
Chapter 9.67 VARIANCES

9.67.050 Basis for Approval, Conditional Approval, or Denial of a Variance.


- (a) The Planning Commission may grant a Variance, with such conditions as are found necessary to protect the public health, safety, and general welfare and assure compliance with the provisions and standards included in this Code, provided the following findings can be made:
 - (1) That the strict or literal interpretation and enforcement of the specified regulation(s) would result in practical difficulty or unnecessary physical hardships inconsistent with the objectives of this Chapter; and
 - (2) That there are exceptional or extraordinary circumstances or conditions applicable to the subject property or to the intended use of the property which do not apply generally to other properties in the same zoning district; and
 - (3) That the strict or literal interpretation and enforcement of the specified regulation(s) would deprive the applicant of privileges enjoyed by the owners of other properties in the same zoning district with similar constraints; and
 - (4) That the granting of the Variance will not constitute a grant of special privilege inconsistent with the limitations on other properties in the same zoning district with similar constraints; and
 - (5) That the Variance request is made on the basis of a hardship condition and not as a matter of convenience; and
 - (6) That the granting of the Variance will not be detrimental to the public health, safety, or welfare or materially injurious to properties or improvements in the vicinity;
 - (7) That the Variance approval places suitable conditions on the property to protect surrounding properties and does not permit uses which are not otherwise allowed in the zone;
 - (8) For a Variance to regulations for off-street parking facilities or off-street loading facilities, the following additional findings shall be made:
 - (A) That neither the present nor anticipated future traffic volumes generated by the use of the site or the uses of sites in the vicinity reasonably require the strict or literal interpretation and enforcement of the specified regulation(s).
 - (B) That the granting of the Variance will not result in the parking or loading of vehicles on public streets in such a manner as to interfere with the free flow of traffic on the streets.
 - (C) That the granting of the Variance will not create a safety hazard or any other condition inconsistent with the objectives of this Chapter.
 - (9) That granting of the Variance would not result in adverse impacts, either individually or cumulatively, to coastal access, public recreation opportunities, or coastal resources, and the development would be consistent with the policies of the Local Coastal Program certified land use plan.
- (b) Conditions imposed by the Planning Commission for a Variance may involve any pertinent factors affecting the establishment, operation, or maintenance of the requested use, including, but not limited to:
 - (1) Open spaces and buffer areas.
 - (2) Fences and walls.


Supporting Document #2


- (3) Parking facilities, including vehicular ingress and egress, and the surfacing of parking areas and driveways.
- (4) Public facilities, dedications, and improvements.
- (5) Landscaping maintenance.
- (6) A specified time period within which the variance must be utilized or implemented.


(Added by Ord. 93-16, 11/23/93; amended by Ord. 97-05, 9/9/97)

View the mobile version.

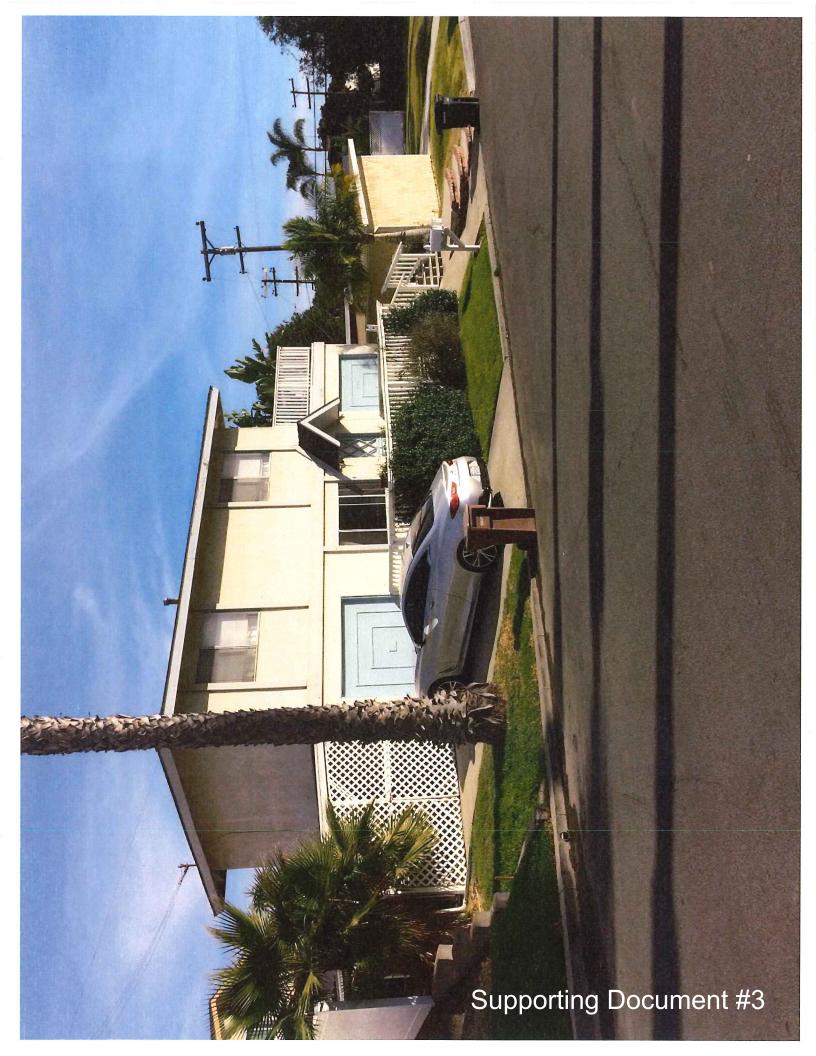

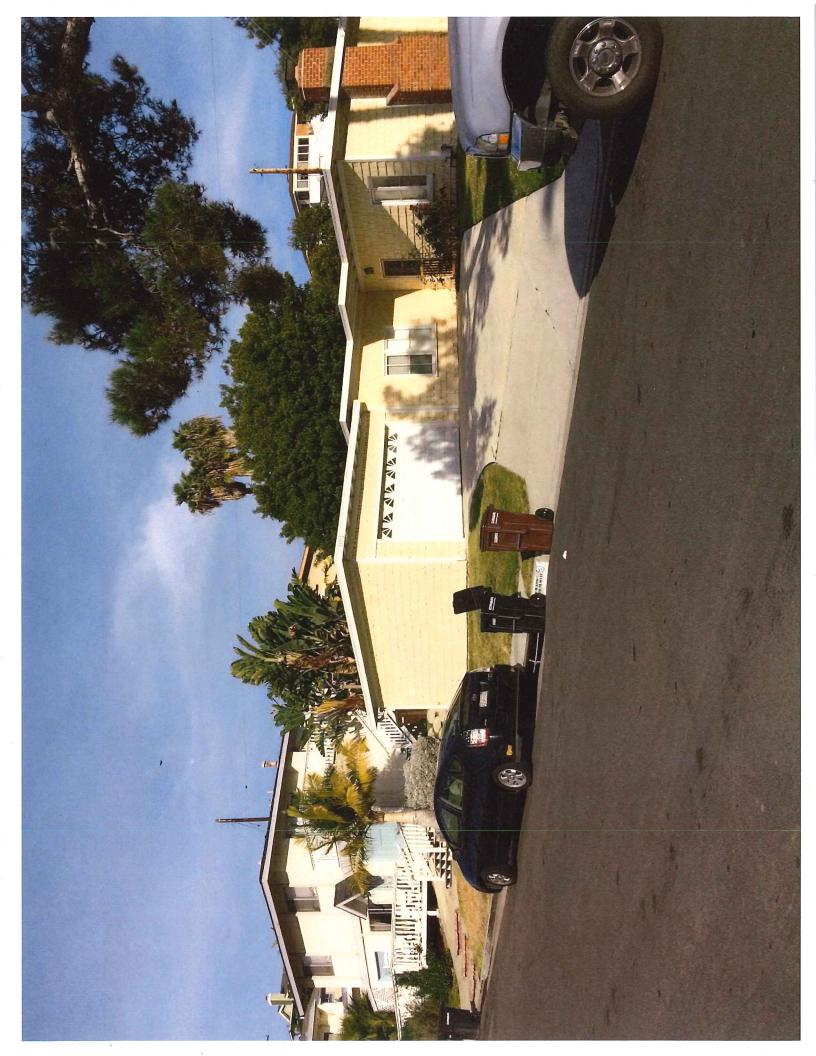

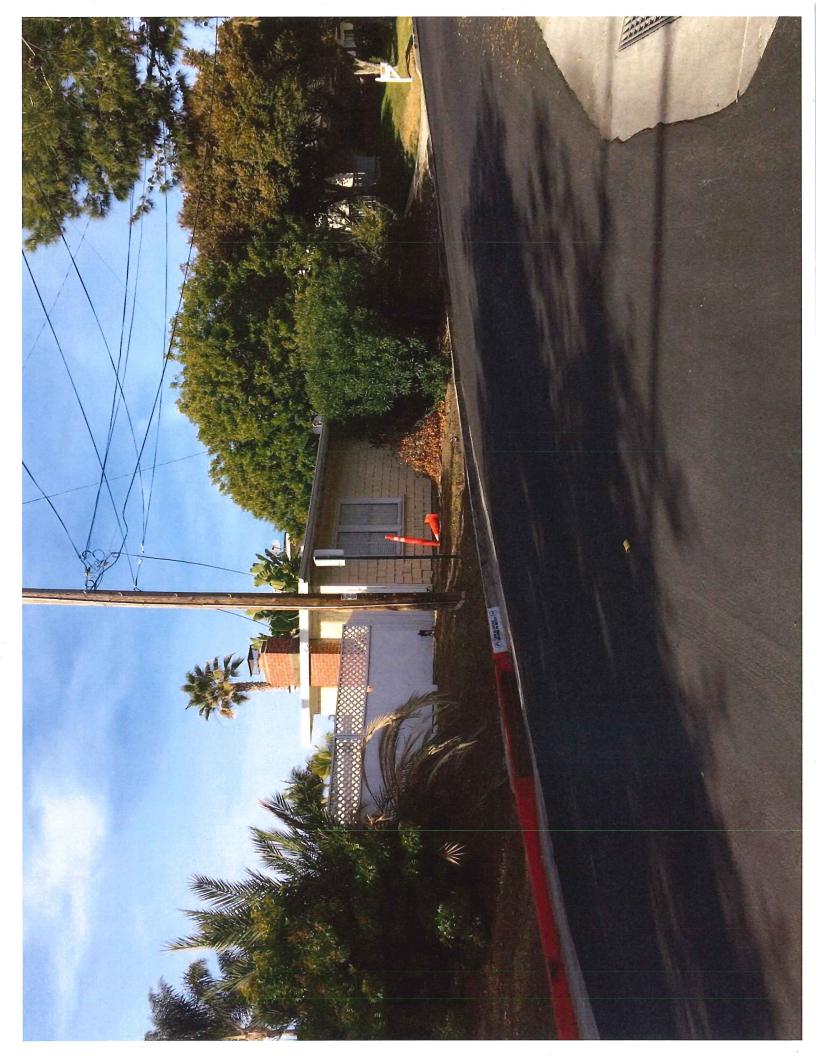

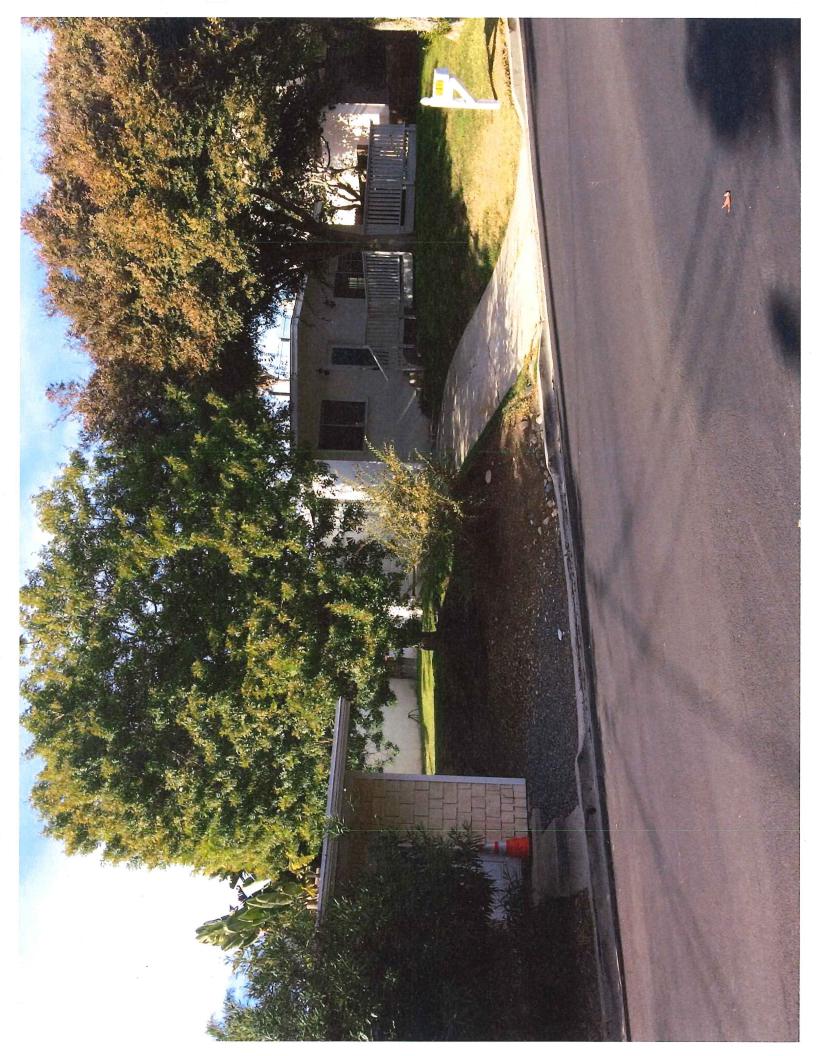

DANA POINT, CALIFORNIA

33950 \$ 33952 COPPER LANTERN AND 33961 MARIANA DRIVE

ABBREVIATIONS

	AND	E.	EAST	LAB.	LABORATORY
_	ANGLE	EA.	EACH	LAM.	LAMINATE
•	AT	E.D.F	DRINK FOUNTAIN	LAY.	LAVATORY
<u> </u>	CENTERLINE	E.J.	EXPANSION JOINT	LKR.	LOCKER
<u>-</u>	DIAMETER OR ROUND	EL.	ELEVATION	LT.	LIGHT
,	POUND OR NUMBER	ELEC.	ELECTRICAL	i.	LIOTT
Ξ)	EXISTING	ELEY.	ELEVATOR		a parate pula p
/		EMER.	EMERGENCY	MAX.	MAXIMUM
.B.	ANCHOR BOLT	ENGL.	ENCLOSED	M.C.	MEDICINE CABINET
.D. BY.	ABOVE			M.B.	MACHINE BOLT
		E.P.	ELECTRICAL PANELBOARD	MECH.	MECHANICAL
COUS.	ACOUSTICAL	EQ.	EQUAL	MEMB.	MEMBRANE
D.	AREA DRAIN	EQPT.	EQUIPMENT	MET.	METAL
2J.	ADJUSTABLE	E.M.C.	ELECTRIC WATER COOLER	MFG	MANUFACTURING
F.F.	ABOVE FINISH FLOOR	EXST.	EXISTING	MFR.	MANUFACTURER
SGR.	AGGREGATE	EXP.	EXPANSION	MH.	MANHOLE
	ALUMINUM	EXPO.	EXPOSED	MIN.	MINIMUM
LUM.	ALUMINUM	EXT.	EXTERIOR	MIR.	MIRROR
•	ANGLE			MISC.	MISCELLANEOUS
PPROX.	APPROXIMATE	F.A.	FIRE ALARM	M.O.	MASONRY OPENING
RCH.	ARCHITECT	F.B.	FLAT BAR		
RCH'L.	ARCHITECTURAL	F.D.	FLOOR DRAIN	MTD.	MOUNTED
SPH.	ASPHALT	FDN.		MUL.	MULLION
e: 11.	2 No. 2 12 No. 1		FOUNDATION EIRE EXTINGUES	N.	NORTH
			FIRE EXTINGUISHER	N.I.C.	NOT IN CONTRACT
_		F.E.C.	FIRE EXTINGUISHER CABINET		
D.	BOARD	F.F.	FINISH FLOOR	NO. OR #	NUMBER
TUM.	BITUMINOUS	F.G.	FINISH GRADE	NOM.	NOMINAL
LDG.	BUILDING	F.H.C.	FIRE HOSE CABINET	N.T.S.	NOT TO SCALE
_K.	BLOCK	FIN.	FINISH		
LKG.	BLOCKING	FL.	FLOOR	0/	OVER
_T.	BOLT	FLASH.	FLASHING	O.A.	OVERALL
서 .	BEAM	FLUOR.	FLUORESCENT	OBS.	OBSCURE
OT.	ВОТТОМ	F.O.C.	FACE OF CONCRETE	0.0.	ON CENTER
		F.O.F.	FACE OF FINISH	O.D.	OUTSIDE DIAMETER (DIM.)
AB.	CABINET	F.O.M.		OFF.	OFFICE
.B.	CATCH BASIN		FACE OF MULLION	O.H.C.	OVERHEAD CABINET
		F.O.S.	FACE OF STUDS	O.H.C. OPNG.	
EM.	CEMENT	FPRF.	FIREPROOF		OPENING
ER.	CERAMIC	FRAM'G	FRAMING	OPP.	OPPOSITE
.l.	CAST IRON	F.S.	FULL SIZE		
.G.	CORNER GUARD	FT.	FOOT OR FEET	PRCST.	PRECAST
_G.	CEILING	FTG.	FOOTING	PL.	PLATE
_KG.	CAULKING	FURR.	FURRING	P.LAM.	PLASTIC LAMINATE
LO.	CLOSET	FUT:	FUTURE	PLAS.	PLASTER
R	CLEAR	101.	101014	PLYND.	PLYWOOD
0.	CASED OPENING	<i>P</i> *. \$	يسم مرز ز خ سر	PNL.	PANEL
0. OL.	COLUMN	GA.	GAUGE	PTD.	PAINTED
		GALY.	GALVANIZED		
ONC.	CONCRETE	G.B.	GRAB BAR	PLUMB.	PLUMBING
ONN.	CONNECTION	GL.	GLASS	PLYMD.	PLYWOOD
ONSTR.	CONSTRUCTION	GND.	GROUND	旦_	PROPERTY LINE
ONT.	CONTINUOUS	GR.	GRADE	PR.	PAIR
O.F.	CORNER OF FINISH	GYP.	GYPSUM	PT.	POINT
ORR.	CORRIDOR	GYP. BD.	GYPSUM BOARD	PREFAB	PREFABRICATED
SK.	COUNTERSUNK	6.B.	GYPSUM BOARD	P.T.D.	PAPER TOWEL DISPENSER
NTR.	COUNTER	6.N.B.	GYPSUM WALL BOARD	P.T.D/R	COMBINATION PAPER TOW
R.	CENTER	V.F 3.LJ.	VII JOH F VIIII DUMIN		DISPENSER & RECEPTACLE
	remaind to a part of	H.B.	HOSE BIBB	PTN.	PARTITION
21	DOUBLE	H.C.	HOLLOW CORE	P.T.R.	PAPER TOWEL RECEPTACE
3L.	DOUBLE	HDMD.	HARDWOOD		
EPT.	DEPARTMENT	HDME.		Q.T.	QUARRY TILE
F.	DRINKING FOUNTAIN		HARDWARE	g==5	ner
ET.	DETAIL	H.M.	HOLLOW METAL	R.	RISER
Д,	DIAMETER	HORIZ.	HORIZONTAL	RAD.	RADIUS
М.	DIMENSION	HR.	HOUR	R	RADIUS
٧.	DOMN	HT.	HEIGHT	R.D.	ROOF DRAIN
 O.	DOOR OPENING	H.V.A.C	HEATING VENTILATING	REF.	REFERENCE
<i>૦.</i> ₹.	DOOR		AIR CONDITIONING	REFR.	REFRIGERATOR
		HORZ	HORIZONTAL	REV	REVERSE
5.	DOWNSPOUT			REINF	
5.P.	DRY STANDPIPE	I.D.	INSIDE DIAMETER		REINFORCED REINFORCED
N	DISHWASHER	INSUL.	INSULATION	RGTR.	REGISTER
ng's	DRAWINGS			REQ.	REQUIRED
NR.	DRAWER	INT.	INTERIOR	RESIL.	RESILIENT
				RM.	ROOM
		JAN.	JANITOR	R.O.	ROUGH OPENING
		. IT	LOINT		

REDWOOD

RAIN WATER LEADER

ORDINANCES ADOPTED BY THE LOCAL GOVERNING AGENCIES AS WELL AS THE FOLLOWING: CODE: 2016 CALIFORNIA RESIDENTIAL CODE 2016 CALIFORNIA BUILDING CODE 2016 CALIFORNIA PLUMBING CODE 2016 CALIFORNIA MECHANICAL CODE 2016 CALIFORNIA ELECTRICAL CODE 2016 CALIFORNIA ENERGY CODE 2016 CALIFORNIA GREEN BUILDING STANDARDS CODE CITY OF DANA POINT AMENDMENTS

THIS PROJECT SHALL COMPLY WITH ALL REGULATIONS AND

	JURISPICTION:	CITY OF DAN	A POII
	ZONE:	RMF 14	
	CONSTRUCTION TYPE:	V \$	
	OCCUPANCY:	R-5, U	
	SETBACKS:		
	FRONT:	20'-0"	
	REAR:	15'-0"	
	SIDE:	5'-0"	
	MAXIMUM HEIGHT:	28'-0"	
_			

DESIGN DATA

SOLID CORE

SQUARE FEET

SKYLIGHT

SPECIFICATIONS

STANDARD

STORAGE

STRUCTURAL

SOLID MOOD

SYMMETRICAL

TELEVISION

TOP OF WALL

WATER CLOSET

MATER HEATER

TONGUE AND GROOVE

UNLESS OTHERWISE NOTED

SLOPE

SOAP DISPENSER

SANITARY NAPKIN DISPENSER

SCHEDULE

LEGAL DESCRIPTION:

APN: 682./23-18

Lot 10 in Block 2 of Tract No. 862, in the City of Dana Point, Count of Orange, State of California, as shown on a map recorded in Book 30, Pages 34, 35 and 36 of Miscellaneous Maps, records of Orange County, California.

Excepting therefrom all standing, flowing and percolating or other waters in or under said property, together with the right to remove the same by means of wells or tunnels on other property, and all riparian water rights for the use and benefit of said riparian lands as reserved by Chandler-Sherman Corporation in Deed recorded April 1, 1948 in Book 1744, Page 307 of Official Records.

That portion of Lot "X" (Mariana Drive) of Tract No. 862, as shown on a map recorded in Book 30, Pages 34, 35 and 36 of Miscellaneous Maps, records of Orange County, California, described as follows:

Beginning at the Northeasterly terminus of a curve in the Southerly line of Lot 10 of said Tract No. 862, said curve shown as having a radius of 15.00 feet, a central angle of 134 degrees 30 minutes 47 seconds and an arc length of 35.22 feet; thence tangent to said curve and along the Southeasterly line of said Lot 10, North 45 degrees 26 minutes 43 seconds East 36.54; thence South 55 degrees 57 minutes 46 seconds East, 10.89 feet; thence South 34 degrees 02 minutes 14 seconds West 9.80 feet; thence North 55 degrees 57 minutes 46 seconds West, 2.40 feet; thence South 34 degrees 02 minutes 14 seconds West, 27.88 feet to a line that is parallel with and 37.68 feet Southwesterly from the above mentioned course described as South 55 degrees 57 minutes 46 seconds East 10.89 feet; thence North 55 degrees 57 minutes 46 seconds West 16.22 feet along said parallel line to a point on The southeasterly line of said Lot 10, said point being a non-tangent curve, concave northwesterly and having a radius of 15.00 feet, a radial of said curve to said point bears South 37 degrees 11 minutes 28 seconds East: thence Northeasterly 1.93 feet along said curve and Southeasterly line to the point of beginning.

PROJECT SCOPE

CONDOMINIUM CONVERSION OF AN EXISTING 4 UNIT APARTMENT PROJECT WITH THE LOT COVERAGE, PARKING, OPEM SPACE AND LANDSCAPE AREAS MEETING OR EXCEEDING THE CODE REQUIREMENTS

SQUARE FOOTAGE CALCULATIONS:

GROSS LOT AREA: 7,393.00 S.F. PARCEL A: PARCEL B: 489.00 S F. TOTAL: 7,882.00 S.F. LOT COVERAGE: 3106 / 7,882.00=39.4%

OPEN SPACE: REQUIRED: 200 S.F./UNIT UNIT A-1: 210.00 S.F. UNIT A-2: 250.00 S.F. 210.00 S.F. UNIT C: 272.00 S.F. TOTAL: 942.00 S.F.

COMMON AREA: REQUIRED: 2365.00 S.F. (30%) PROVIDED: 2387.00 S.F. (30.25%)

LANDSCAPING:

REQUIRED: 1971.00 S.F. (25%) PROVIDED: 1985.00 S.F. (25.18%)

PROJECT TEAM: REAL ESTATE ADVISORS, INC 3445 YUCAIPA BLVD., SUITE 214 YUCAIPA, CA. 92399

(949) 488-3937 STUDIO 6 ARCHITECTS, INC.

2753 CAMINO CAPISTRANO, A-100 SAN CLEMENTE, CA. 92672 CONTACT: ROBERT WILLIAMS EMAIL: ROB@STUDIO6ARCHITECTS.COM

RDM SURVEYING, INC. 23016 LAKE FOREST DR., SUITE 409 LAGUNA HILLS, CA. 92653

PHONE: (949) 858-2924 CONTACT: RON MEDIMA EMAIL: RDMSURVEYING@COX.NET

SHEET INDEX

ARCHITECTURE

T-1 TITLE/NOTES

A-1 CIVIL SITE/SURVEY/ARCHITECTURAL

A-2 AS-BUILT FLOOR PLANS UNIT A-1 AND A-2

A-3 AS-BUILT ROOF PLAN UNITS A-1 AND A-2

A-4 AS-BUILT EXTERIOR ELEVATIONS UNITS A-1 AND A-2

A-5 AS-BUILT FLOOR PLAN UNIT B

A-6 AS-BUILT ROOF PLAN UNIT B

A-7 AS-BUILT EXTERIOR ELEVATIONS UNIT B

A-8 AS-BUILT FLOOR PLANS UNIT C

A-9 AS-BUILT ROOF PLAN UNIT C

A-10 AS-BUILT EXTERIOR ELEVATIONS UNIT C 5-1 EXISTING TOPOGRAPHIC SURVEY

POOLS, SPAS, WALLS, FENCES, PATIO COVERS. FIRE PITS & OTHER FREESTANDING STRUCTURES REQUIRE SEPARATE REVIEWS AND PERMITS.

PROVIDE PORTABLE TOILET AND HAND WASH STATION PER OSHA REGULATIONS.

PLUMBING FIXTURES:

ALL PLUMBING FIXTURES SHALL BE UPGRADED PER CGBSC 4.303 & CIVIL CODE SECTION 1101.1. AS FOLLOWS:

- TOILETS: 1.28 GPF - SHOWERHEADS (MAX. FLOW): 2.0 GPM @ 80 PSI - LAVATORY FAUCETS (MAX. FLOW): 1.5 GPM @ 60 PSI - KITCHEN FAUCETS (MAX. FLOW): 1.8 GPM @ 60 PSI HOMEOWNER OR GENERAL CONTRACTOR TO PROVIDE A SIGNED COMPLETED COPY OF THE SB407 FORM TO CITY HALL COUNTER STAFF PRIOR TO OBTAINING A

FIRE SPRINKLERS:

A FIRE SPRINKLER SYSTEM CONFORMING TO THE LATEST N.F.P.A. 13D STANDARD SHALL BE INSTALLED. DESIGN UNDER SEPERATE SUBMITTAL.

PARKING ANALYSIS:

4444					dericano
	USE:	EXISTING STALLS PER UNIT:			-1
Constitution of the Consti		COVERED	UNCOVERED	VISITORS	
	1 BEDROOM UNIT A-1				
	REQUIRED:	1.0	0.5	0.2	
	PROVIDED:	1.0	0	1.0	
	1 BEDROOM UNIT A-2				
	REQUIRED:	1.0	0.5	0.2	
	PROVIDED:	1.0	0	1.0	
	1 BEDROOM UNIT B				
	REQUIRED:	1.0	0.5	0.2	
	PROVIDE:	2.0	1.0	1.0	
	2 BEDROOM UNIT C				
	REQUIRED:	1.0	1.0	0.2	
	PROVIDED:	1. 0 .	1.0	1.0	
	TOTAL REQUIRED:	4.0	2.5	0.8	
	TOTAL PROVIDED:	5,0	2.0	1, O ·	
- consistent		TO CONTRACTOR CONTRACTOR CONTRACTOR AND AN ARCHITECTURE OF A STATE OF THE STATE OF		Bratings Charles and the Control of	NAME OF TAXABLE PARTY.

THE EXCESS COVERED PARKING COUNTS TOWARDS UNCOVERED PARKING

STUDIO6ARCHITECTS.COM

PROJECT CONTACT: **BRIAN MUEHLBAUER**

PHONE: (949) 388-5300 FAX: (949) 388-3330 brian@studio6architects.com

PROJECT TEAM:

BRIAN MUEHLBAUER

ROBERT WILLIAMS

CLIENT:

PHONE NUMBER:

ANT

PROJECT NUMBER 2017009


> MILESTONES / REVISIONS DESCRIPTION

LICENSE STAMP:


SHEET TITLE:


TITLE SHEET

SHEET NUMBER:

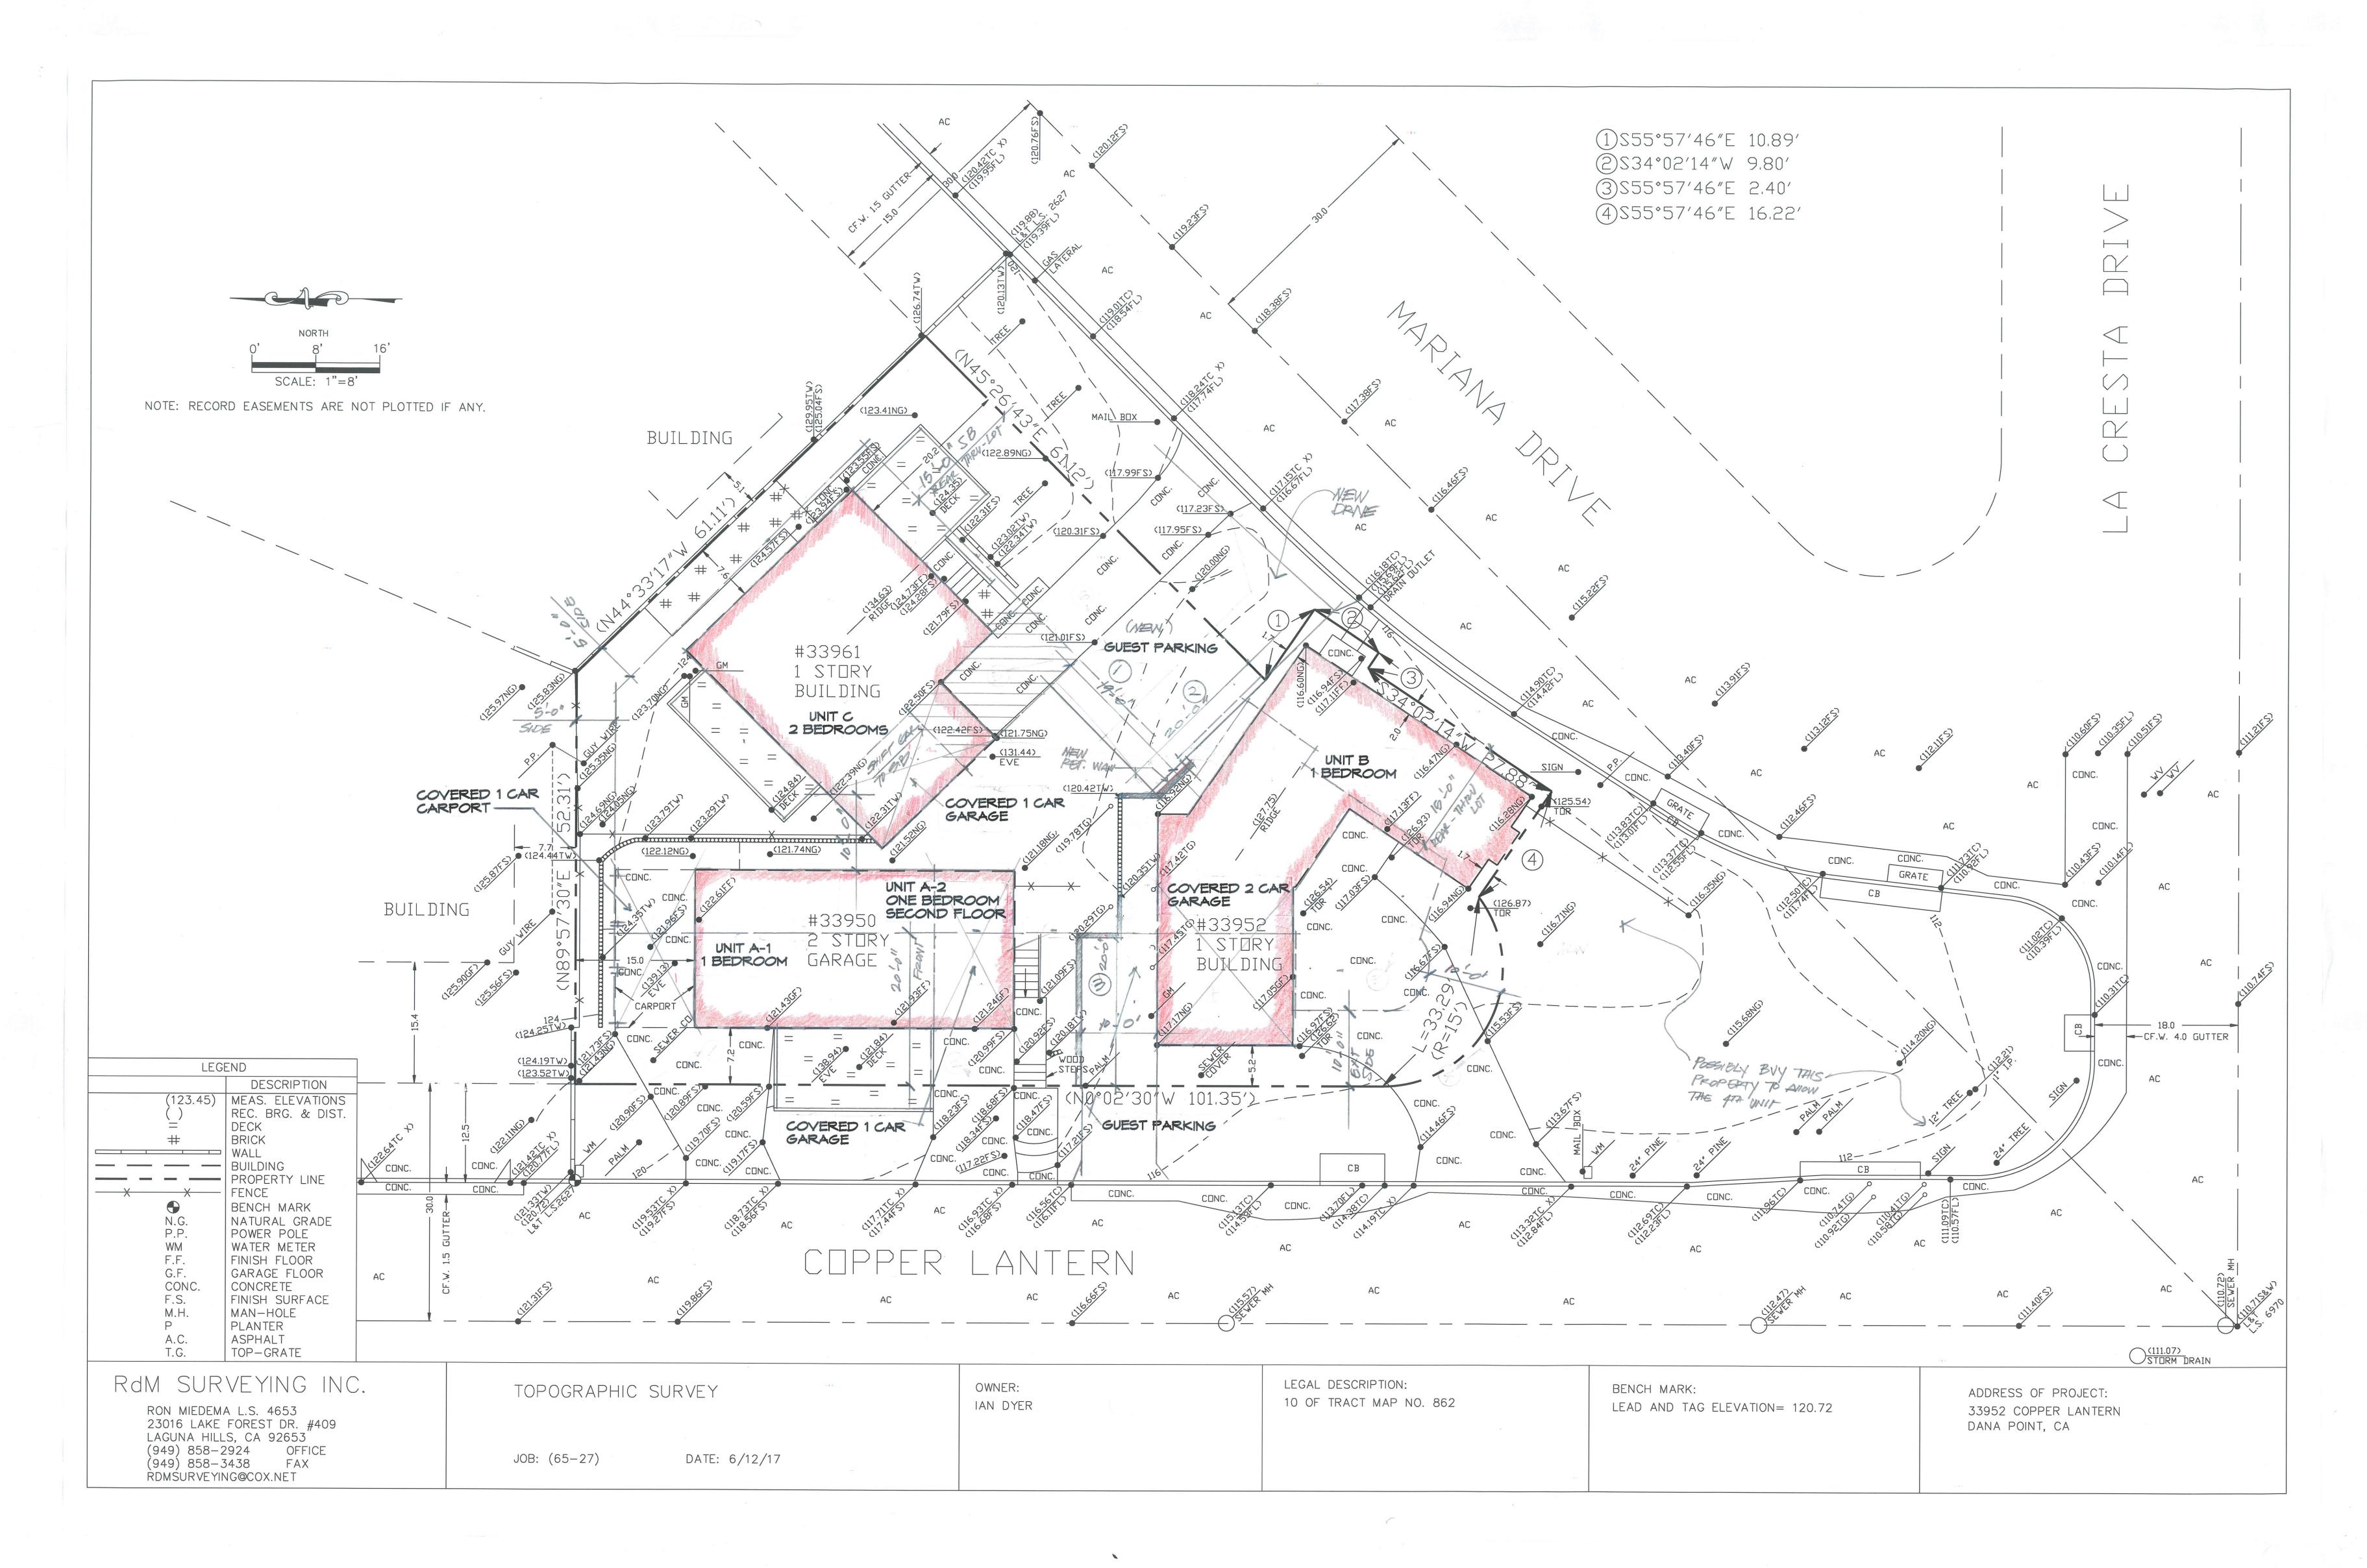




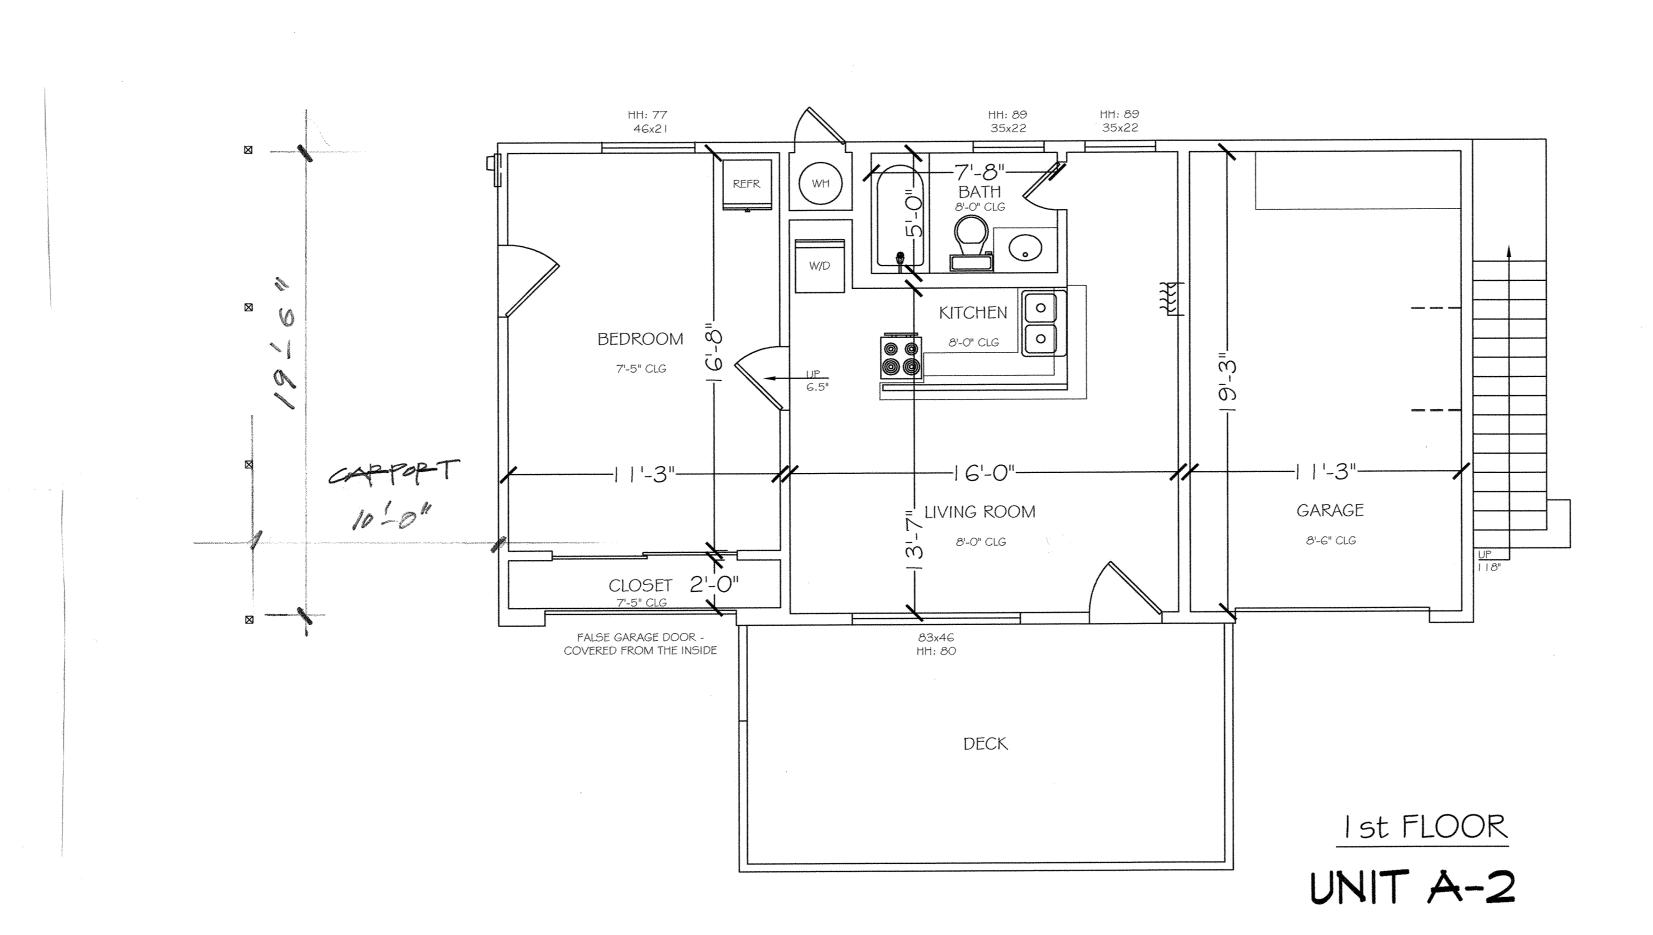

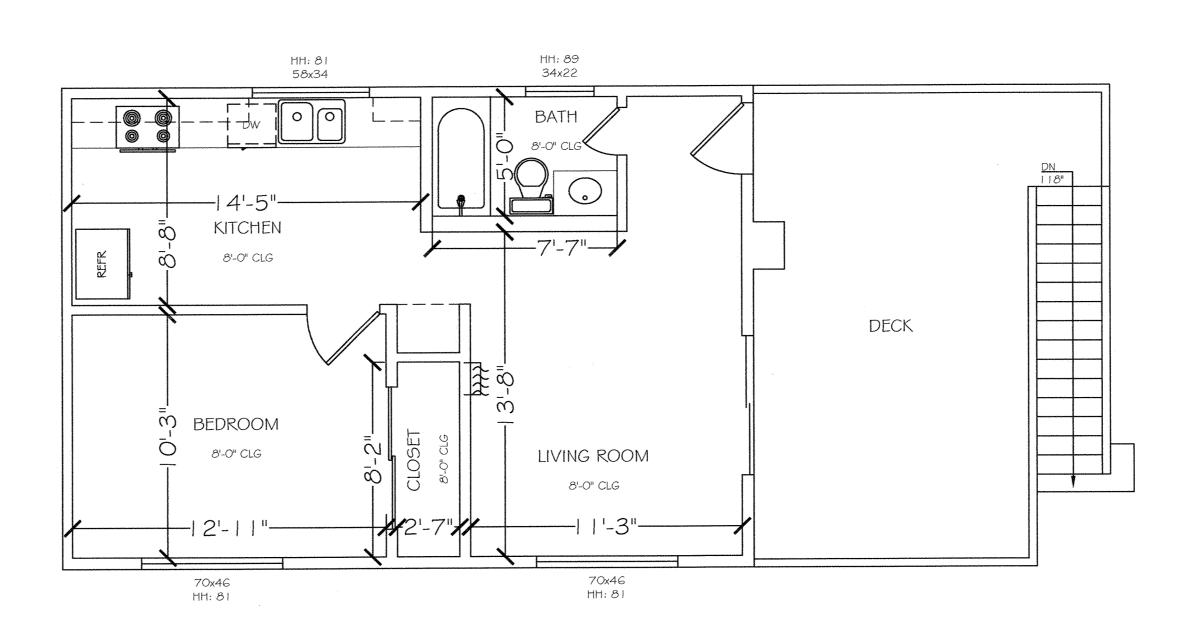

UNIT A-1 2nd FLOOR

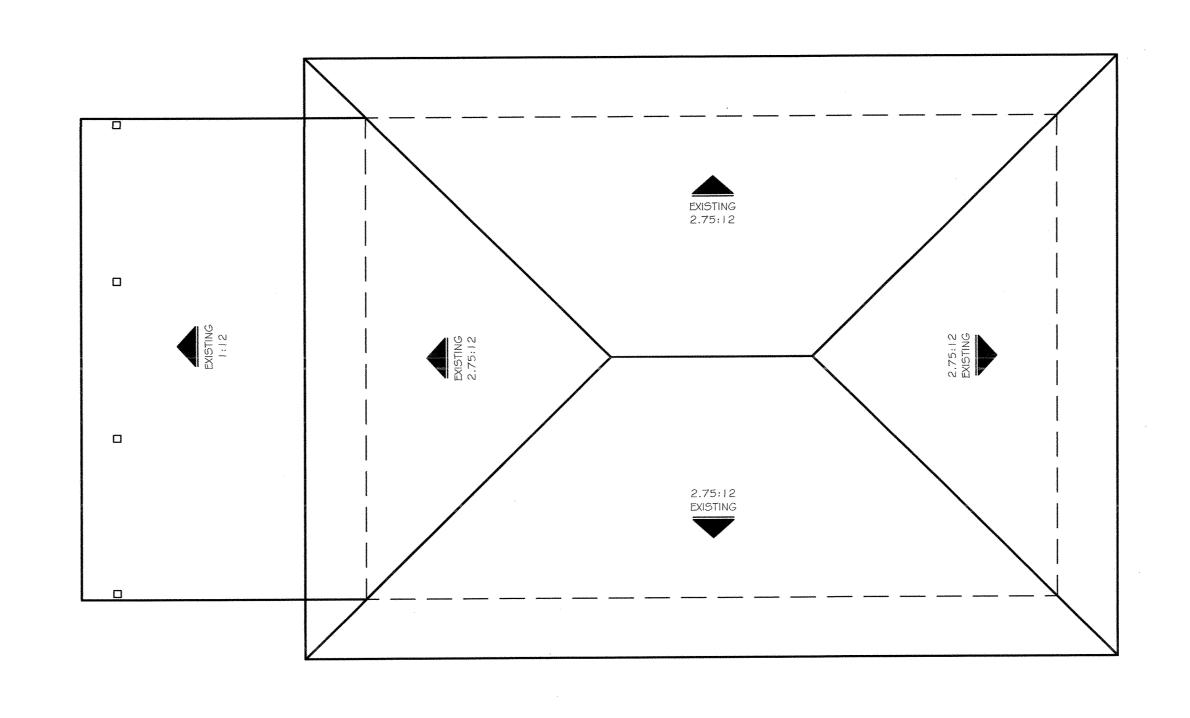


UNIT A-1 & UNIT A-2 ROOF PLAN










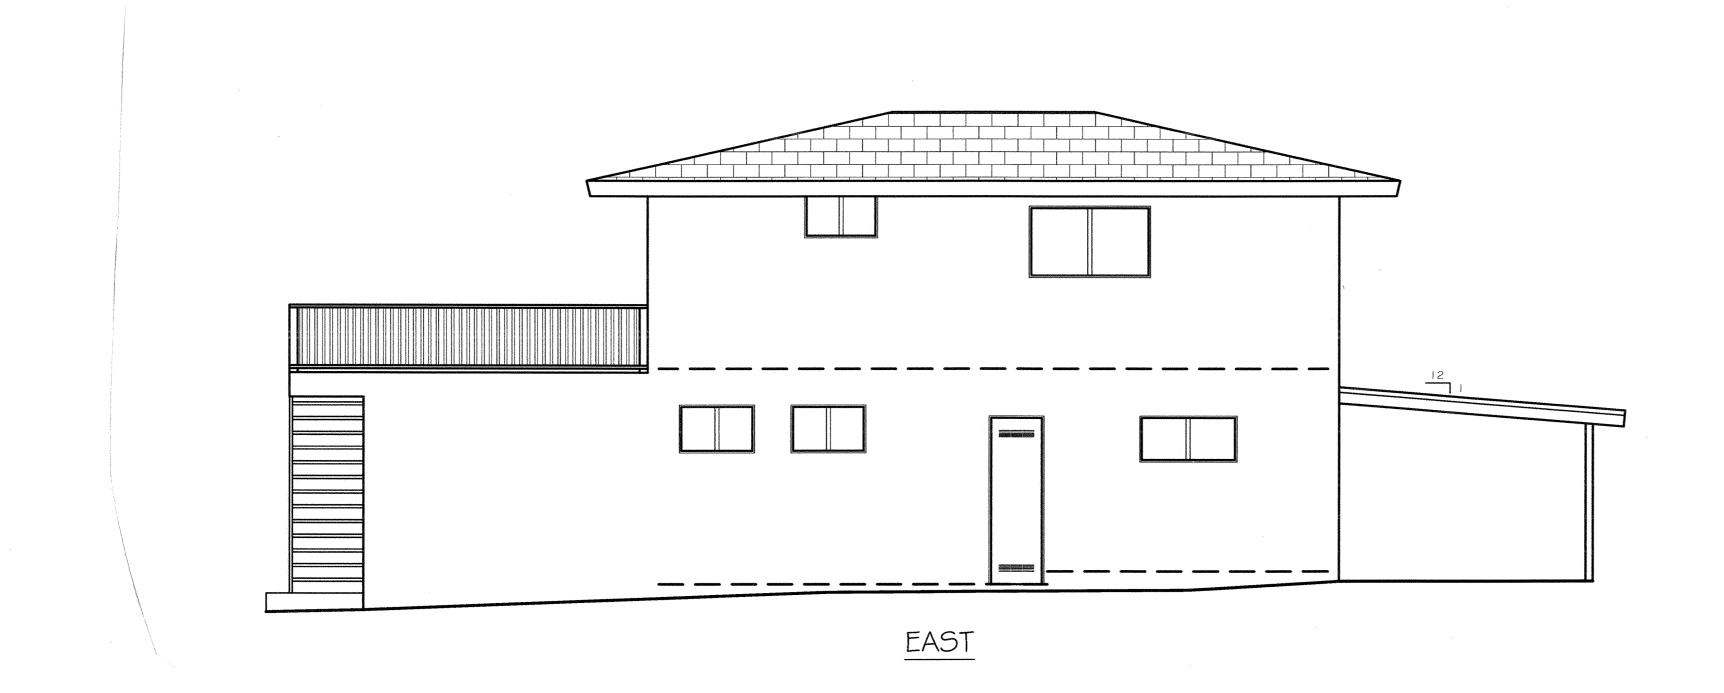


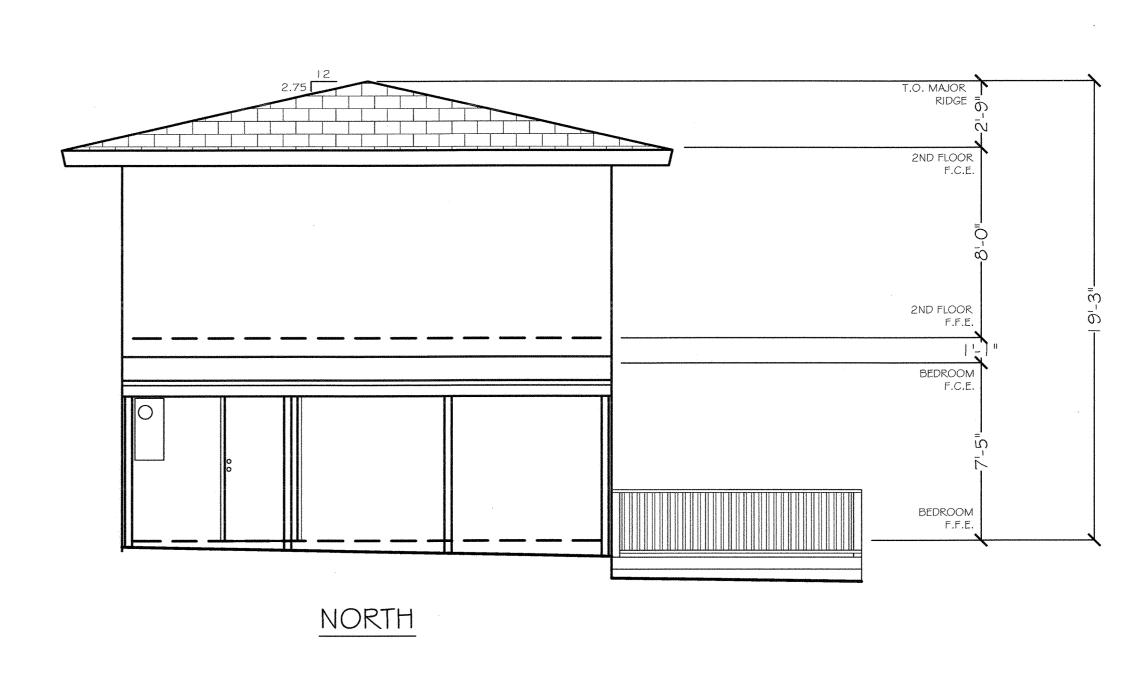


UNIT A-1 & UNIT A-2 ELEVATIONS

COPPER LANTERN



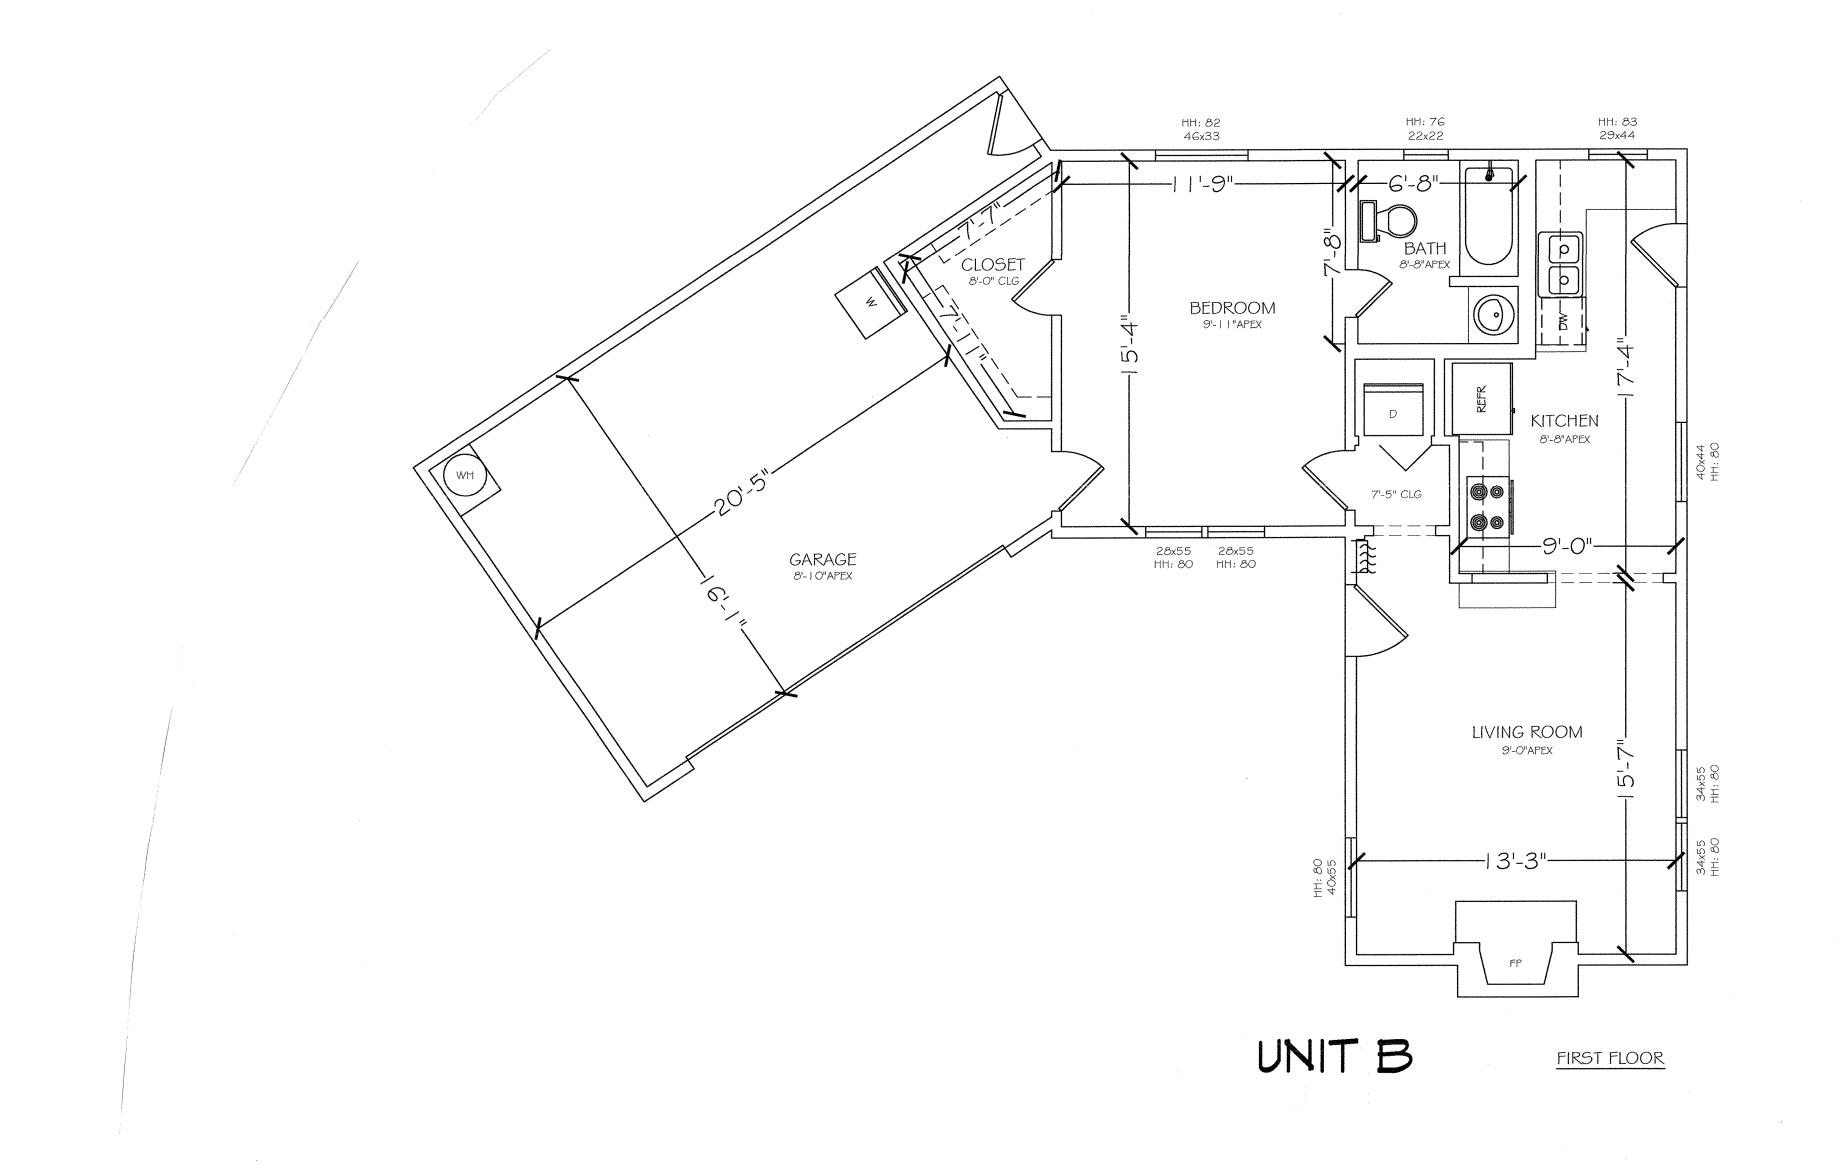




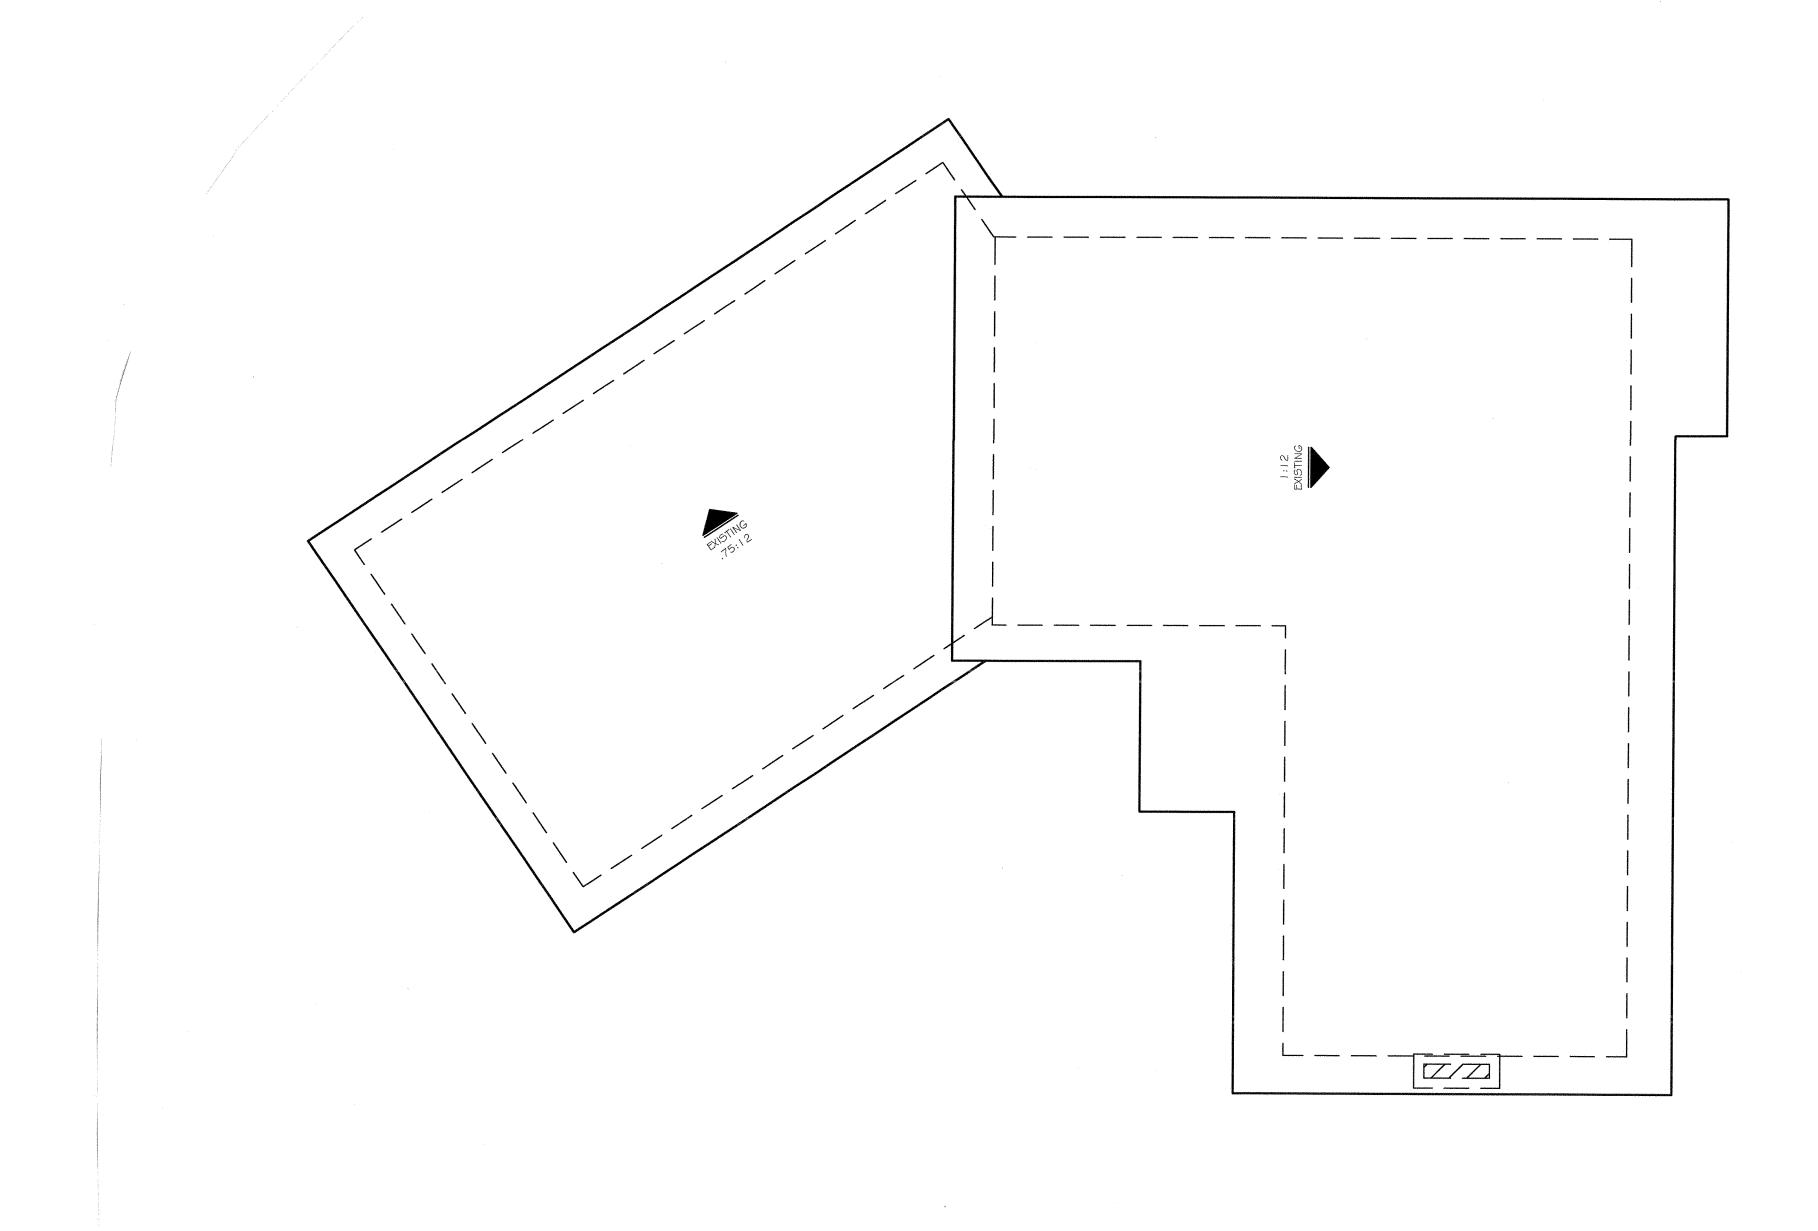

UNIT B ROOF PLAN

COPPER LANTERN




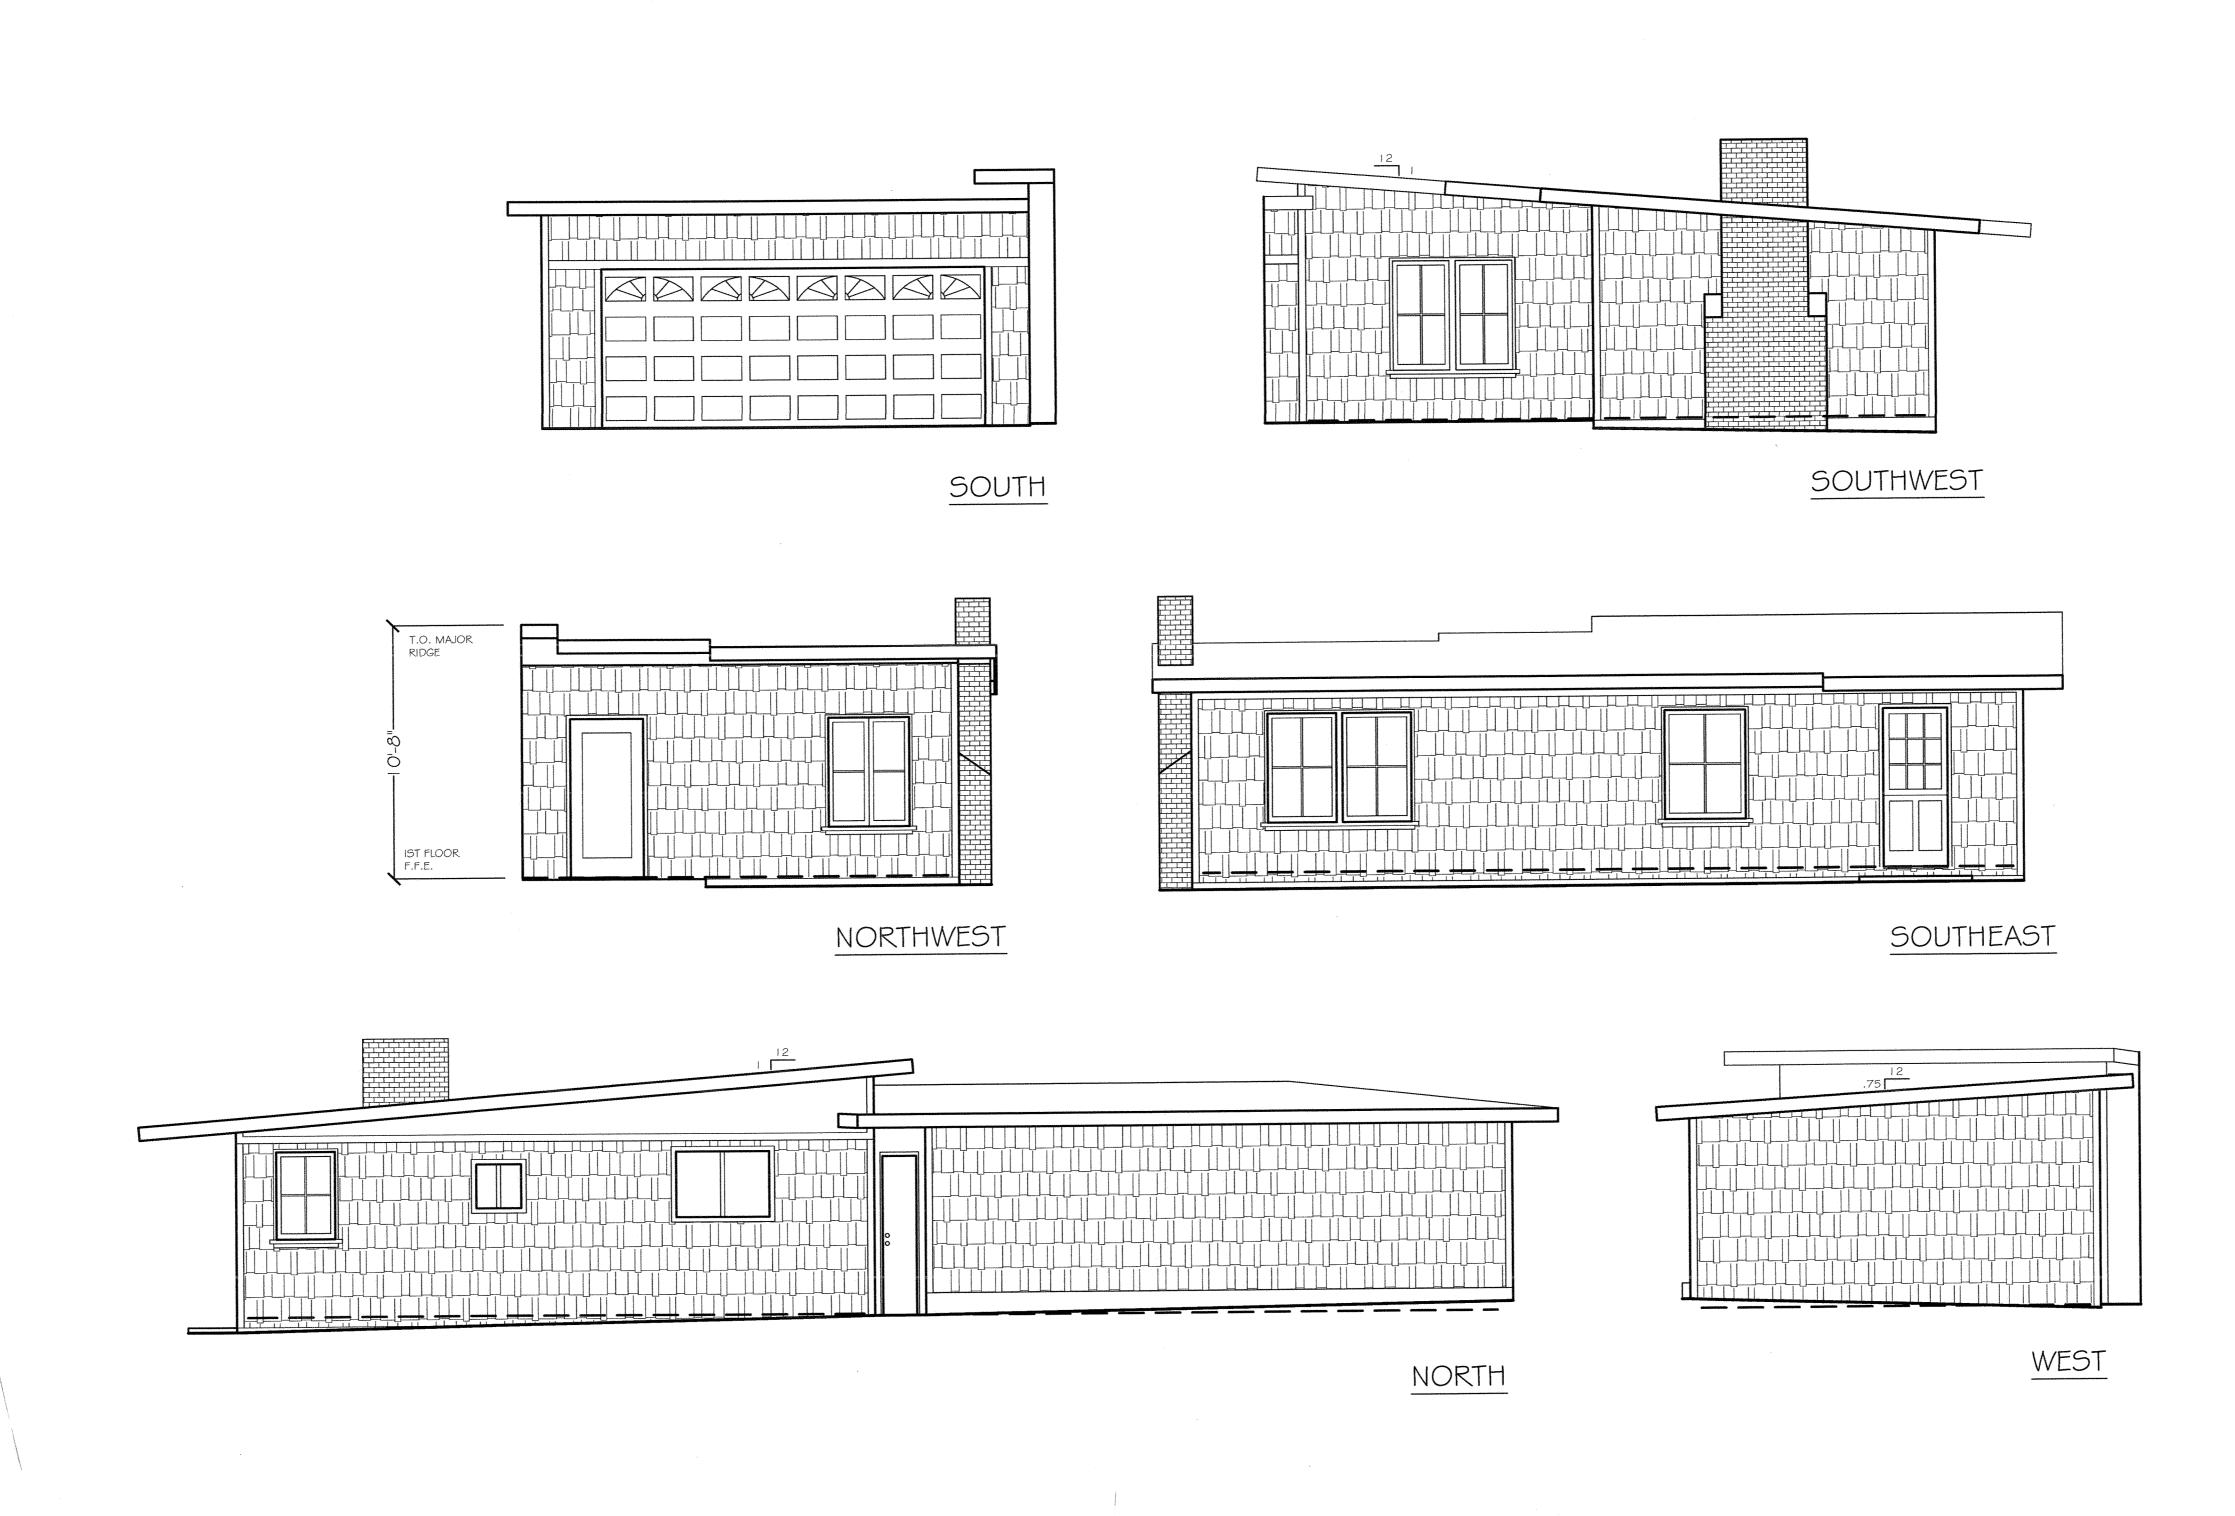


UNIT B ELEVATIONS

COPPER LANTERN



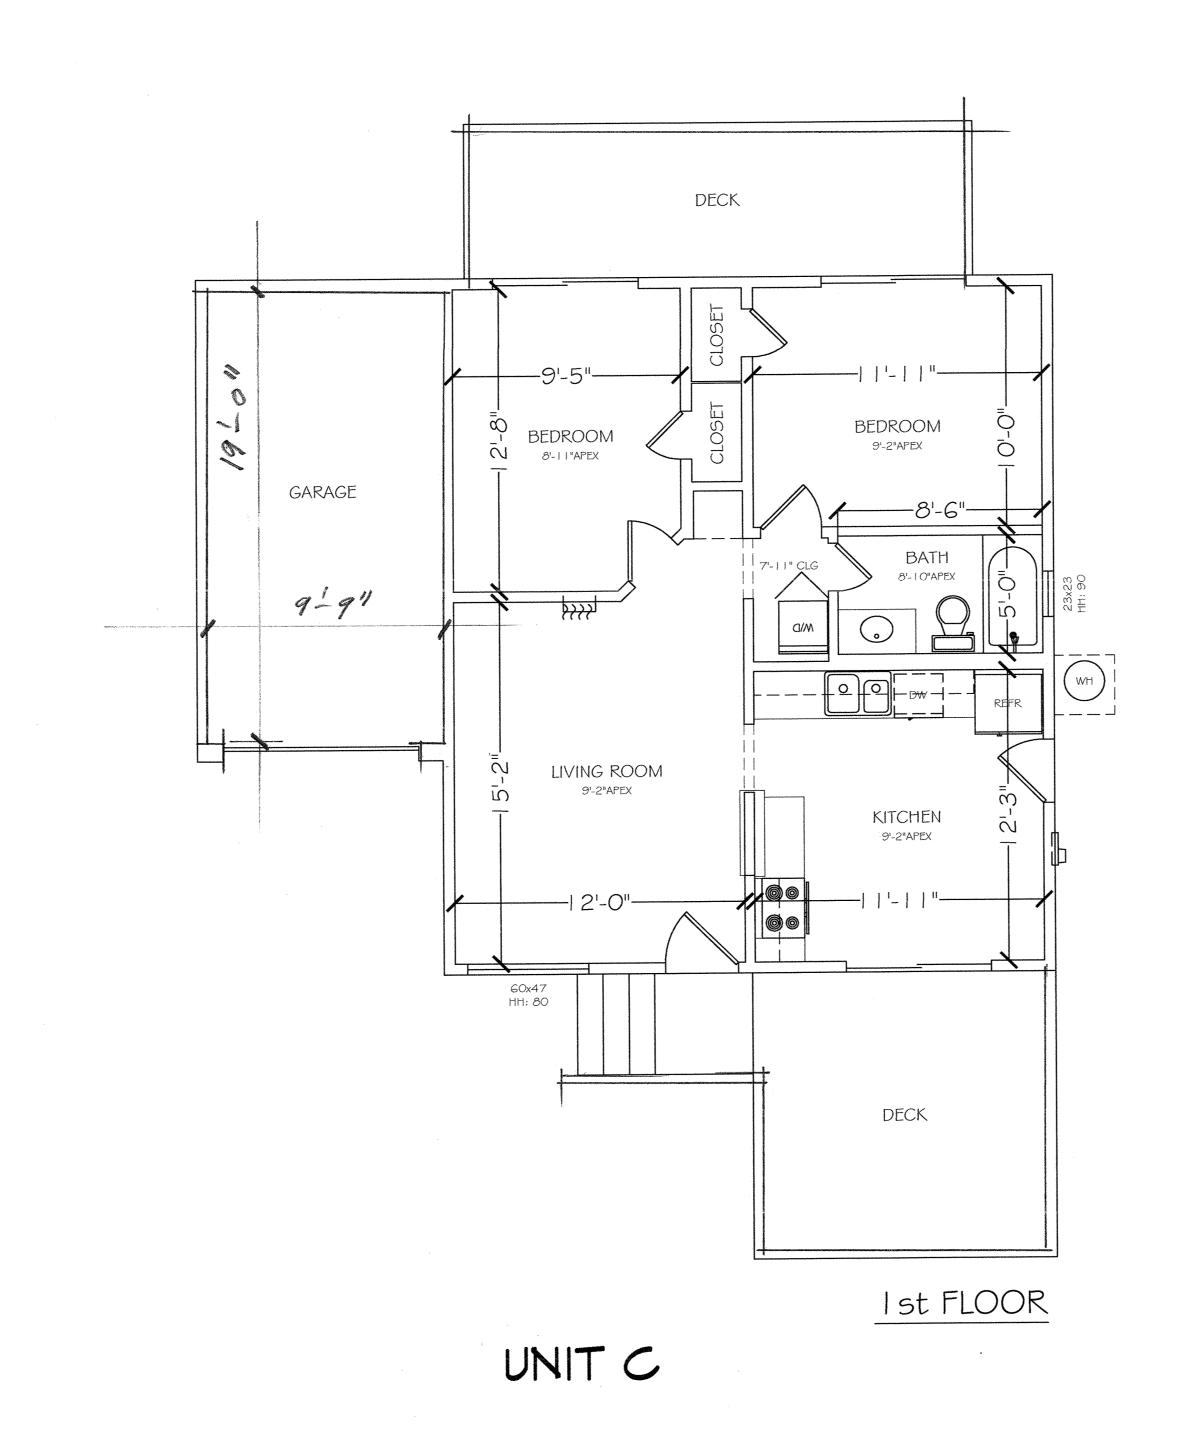




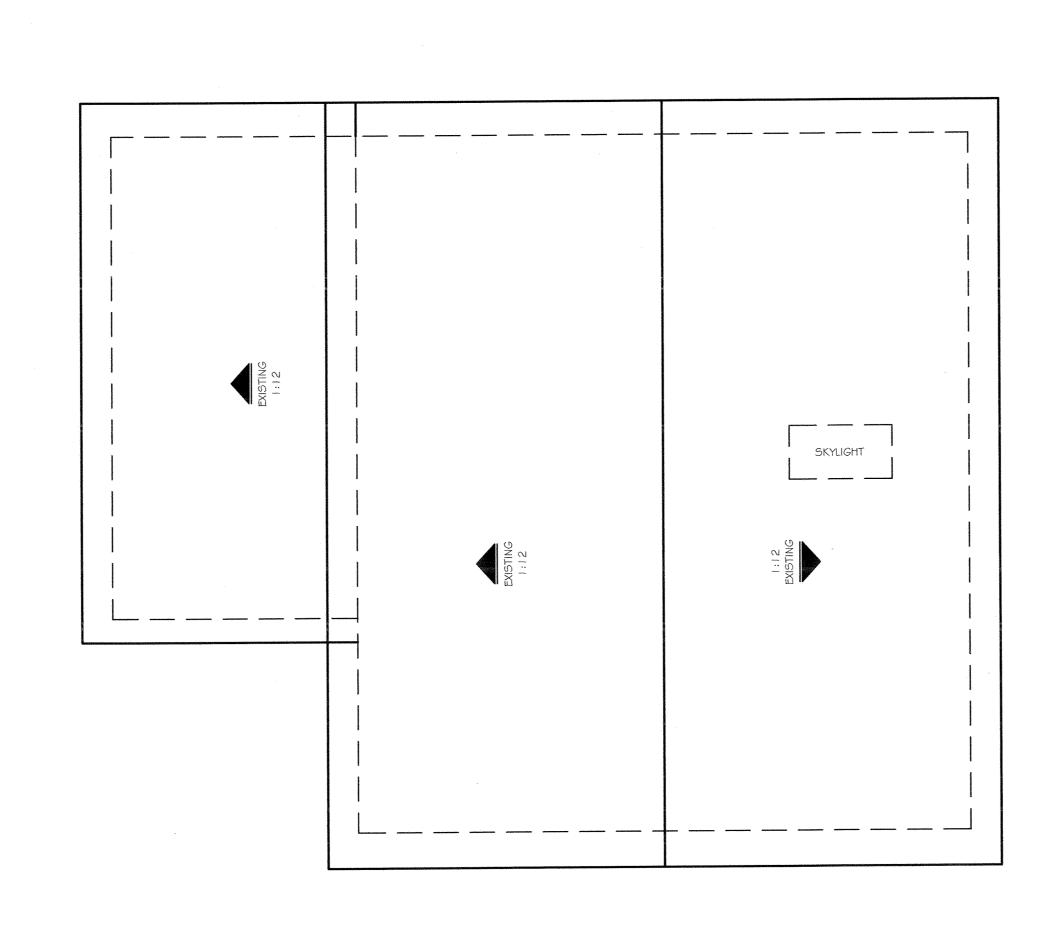


UNIT C ROOF PLAN

COPPER LANTERN



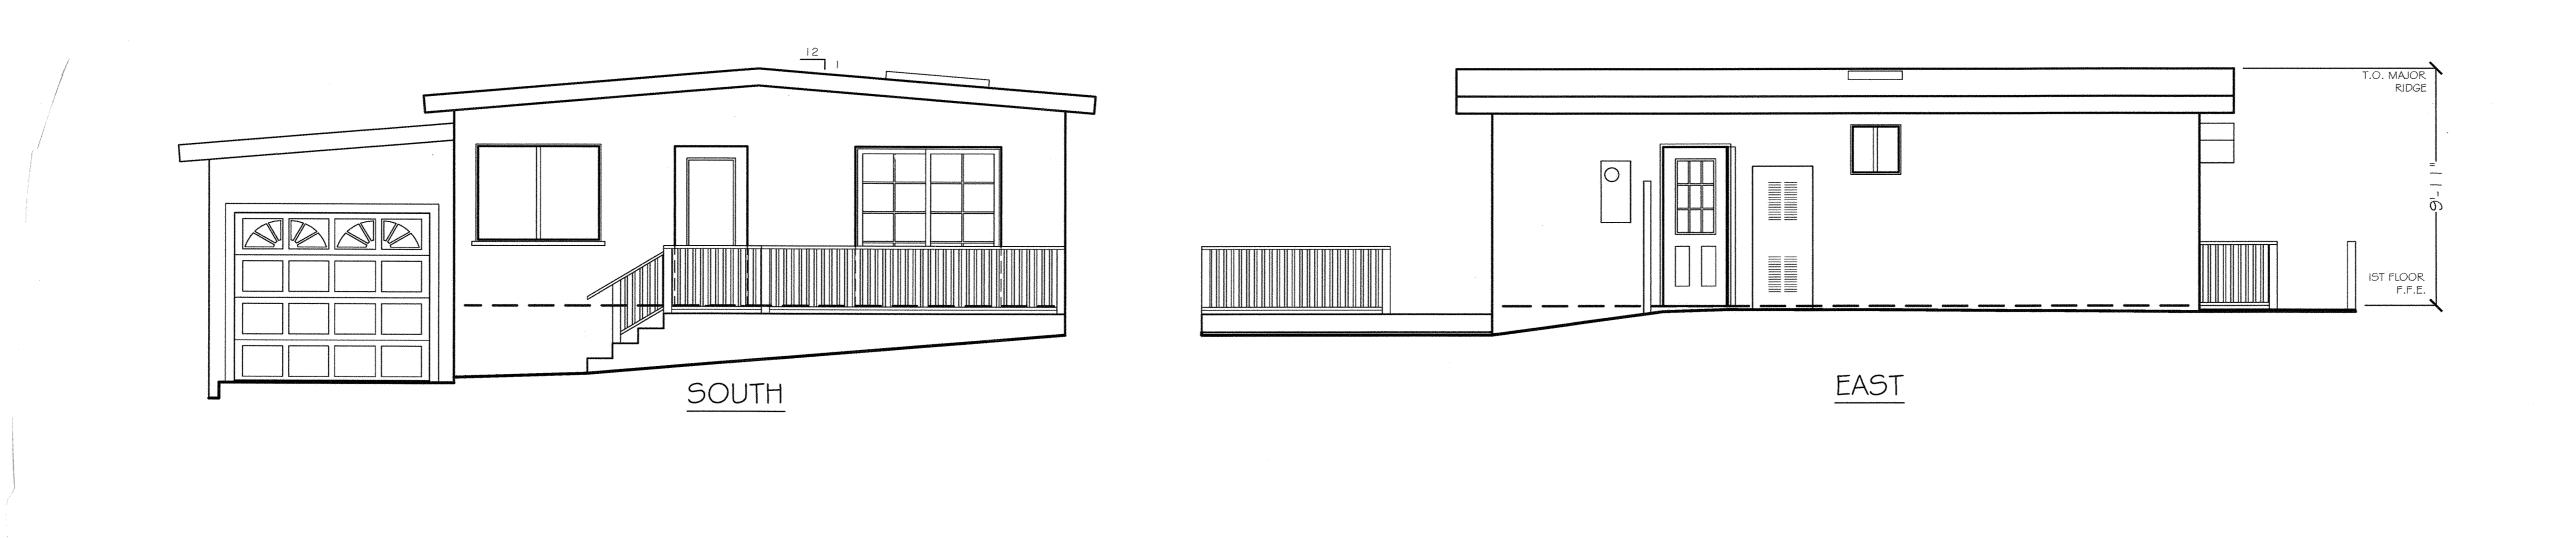

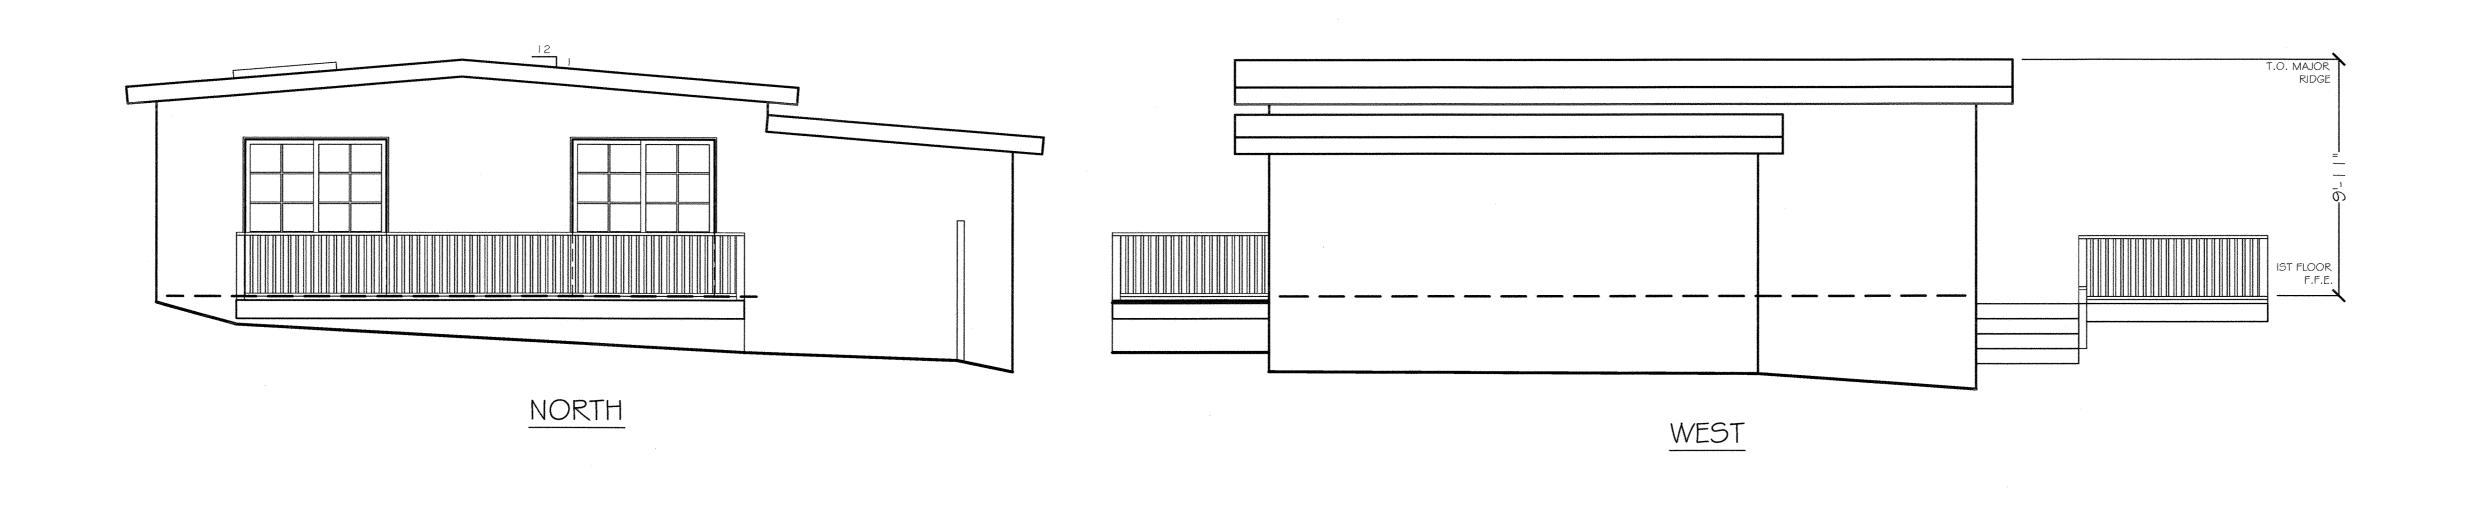

UNIT C ELEVATIONS

COPPER LANTERN

